


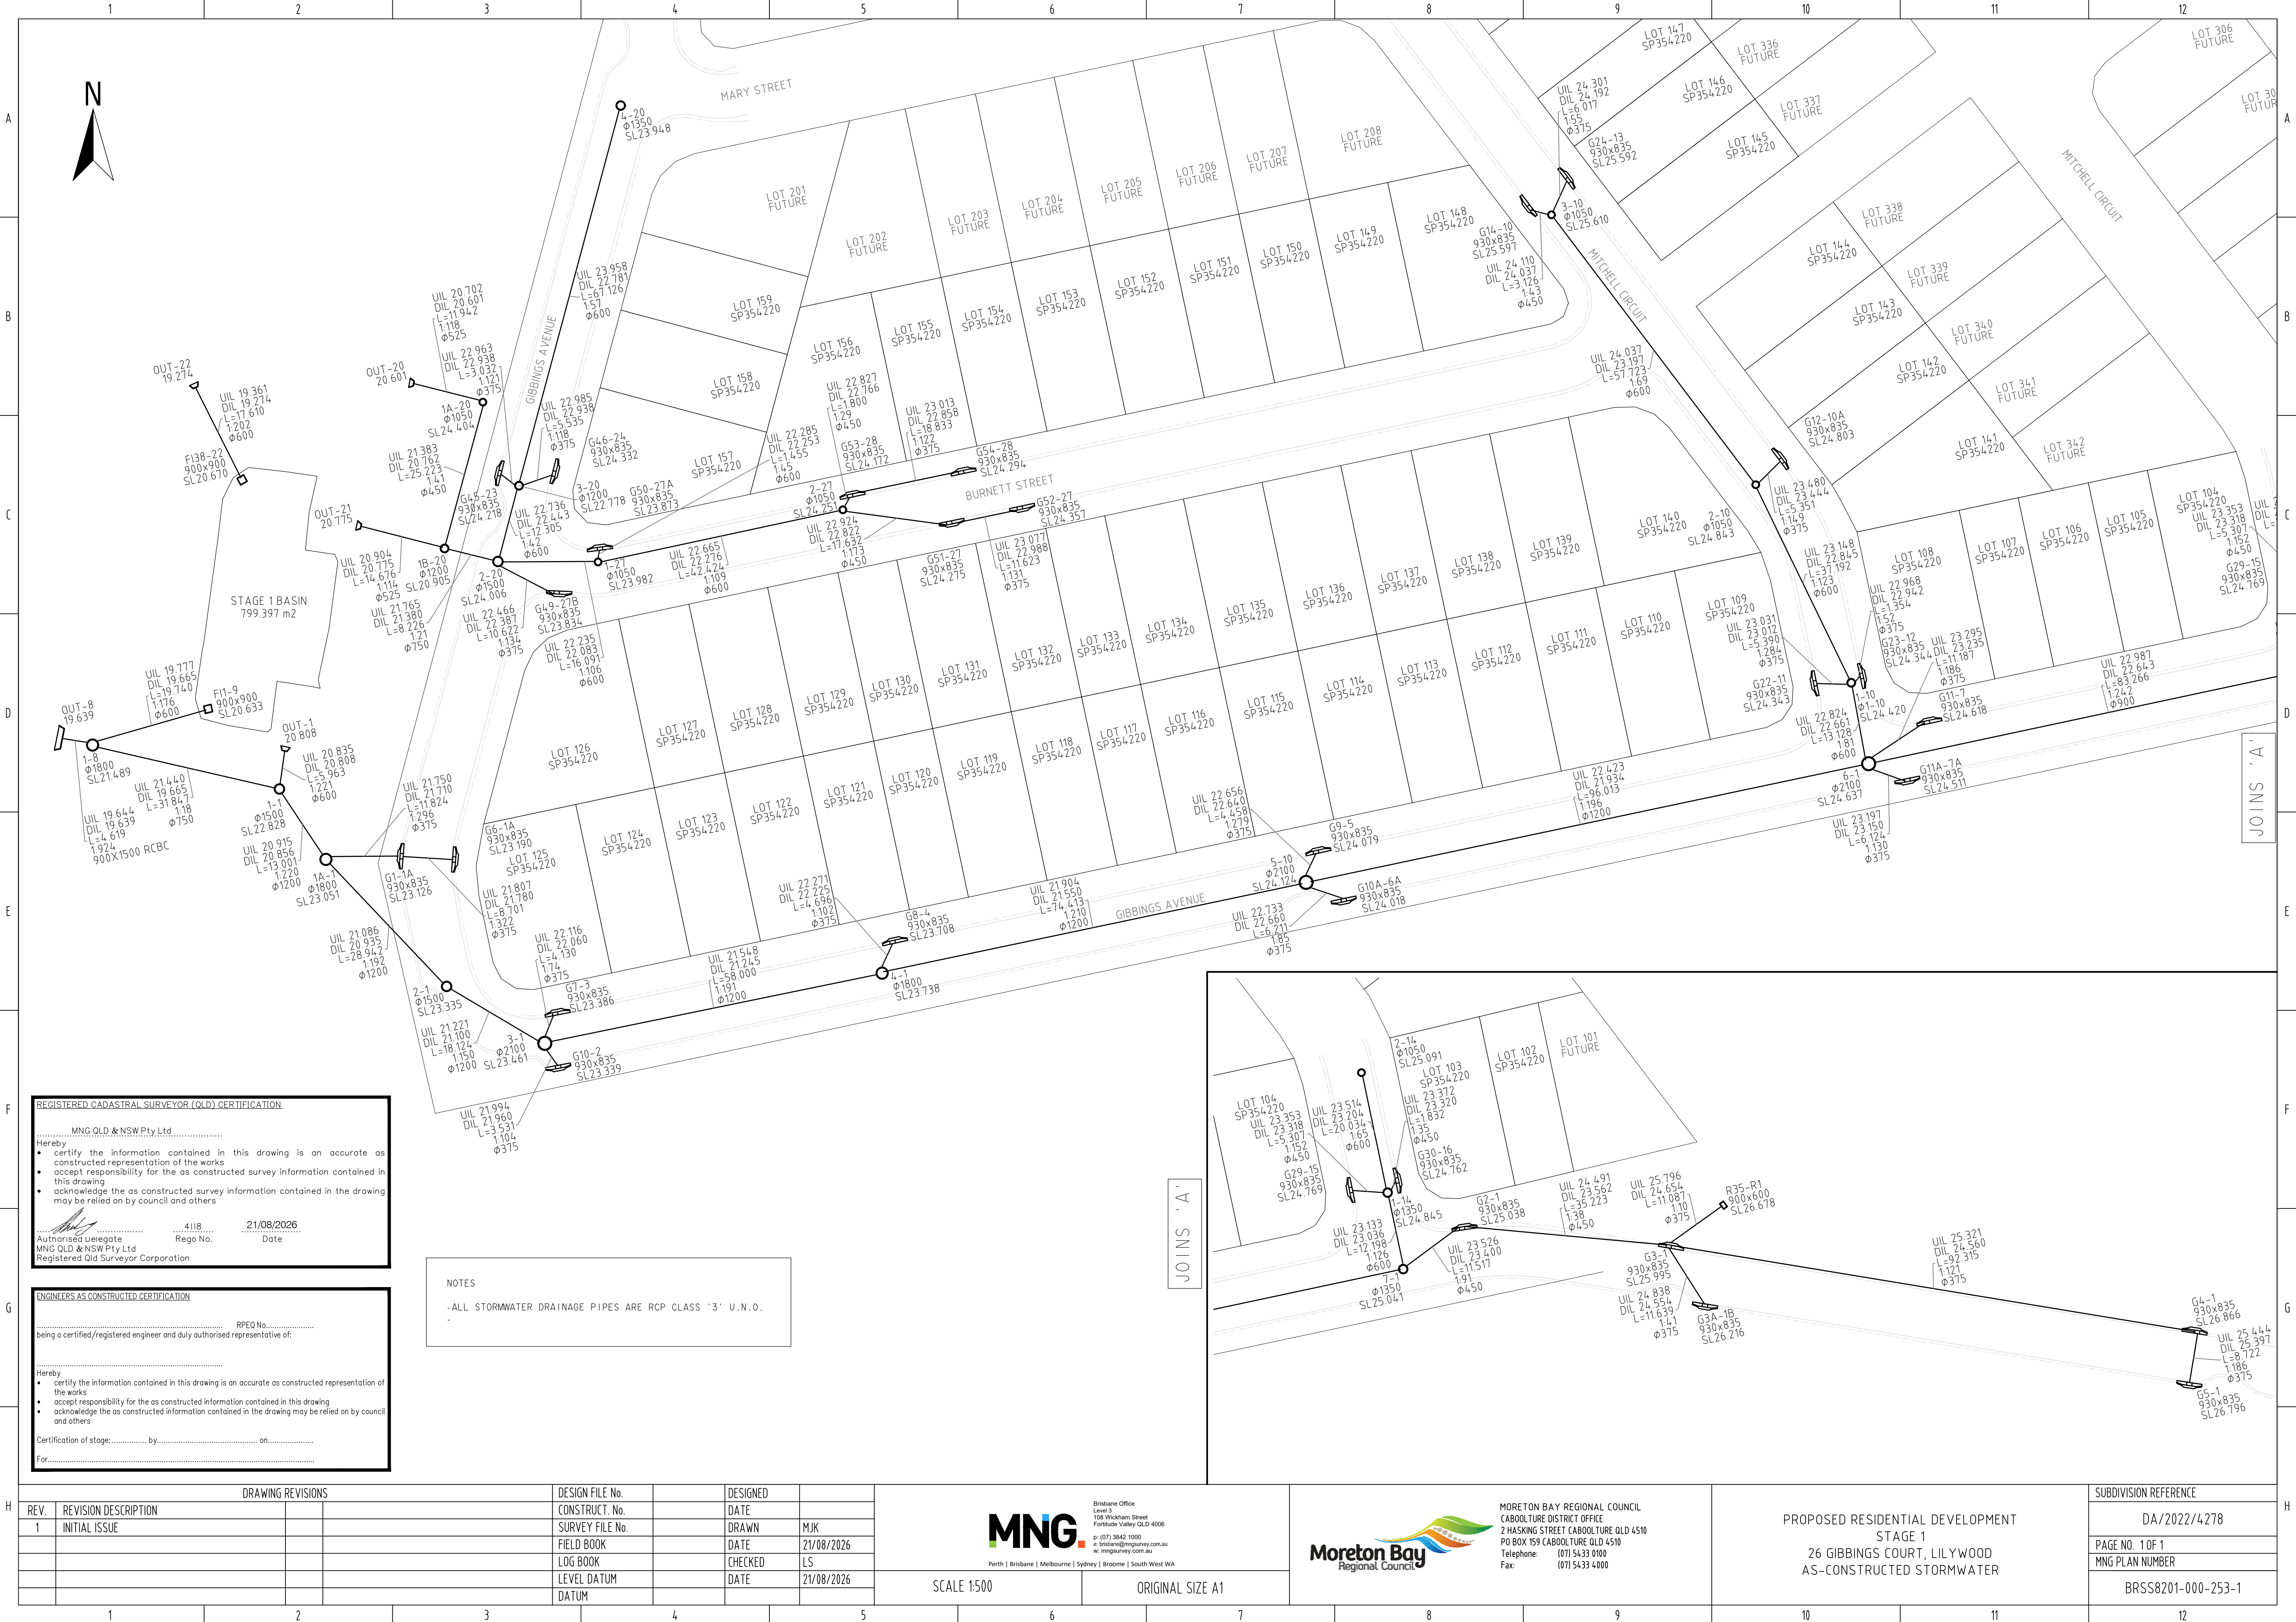

REGISTERED CADASTRAL SURVEYOR (QLD) CERTIFICATION

..... MNG QLD & NSW Pty Ltd

Hereby

- certify the information contained in this drawing is an accurate as constructed representation of the works
- accept responsibility for the as constructed survey information contained in this drawing
- acknowledge the as constructed survey information contained in the drawing may be relied on by council and others

Authorised Delegate
MNG QLD & NSW Pty Ltd
Registered Qld Surveyor Corporation

41/8
Rego No.

21/08/2026
Date

ENGINEERS AS CONSTRUCTED CERTIFICATION

..... RPEQ No.

being a certified/registered engineer and duly authorised representative of:

Hereby

- certify the information contained in this drawing is an accurate as constructed representation of the works
- accept responsibility for the as constructed information contained in this drawing
- acknowledge the as constructed information contained in the drawing may be relied on by council and others

Certification of stage: by on

For

NOTES

- ALL STORMWATER DRAINAGE PIPES ARE RCP CLASS '3' U.N.O.

DRAWING REVISIONS				DESIGN FILE No.	DESIGNED
REV.	REVISION DESCRIPTION			CONSTRUCT. FILE No.	DATE
1	INITIAL ISSUE			FIELD BOOK	DRAWN MJK
				LOG BOOK	DATE 21/08/2026
				LEVEL DATUM	CHECKED LS
				DATUM	DATE 21/08/2026



Brisbane Office
Level 3
108 Wickham Street
Fortitude Valley QLD 4006
P: (07) 3842 1000
E: info@mngsurvey.com.au
W: mngsurvey.com.au

SCALE 1:500

ORIGINAL SIZE A1



MORETON BAY REGIONAL COUNCIL
CABOOLTURE DISTRICT OFFICE
2 HASKING STREET CABOOLTURE QLD 4510
PO BOX 159 CABOOLTURE QLD 4510
Telephone: (07) 5433 0100
Fax: (07) 5433 4000

PROPOSED RESIDENTIAL DEVELOPMENT
STAGE 1
26 GIBBINGS COURT, LILYWOOD
AS-CONSTRUCTED STORMWATER

SUBDIVISION REFERENCE	
DA/2022/4278	
PAGE NO. 1 OF 1	MNG PLAN NUMBER
BRSS8201-000-253-1	