
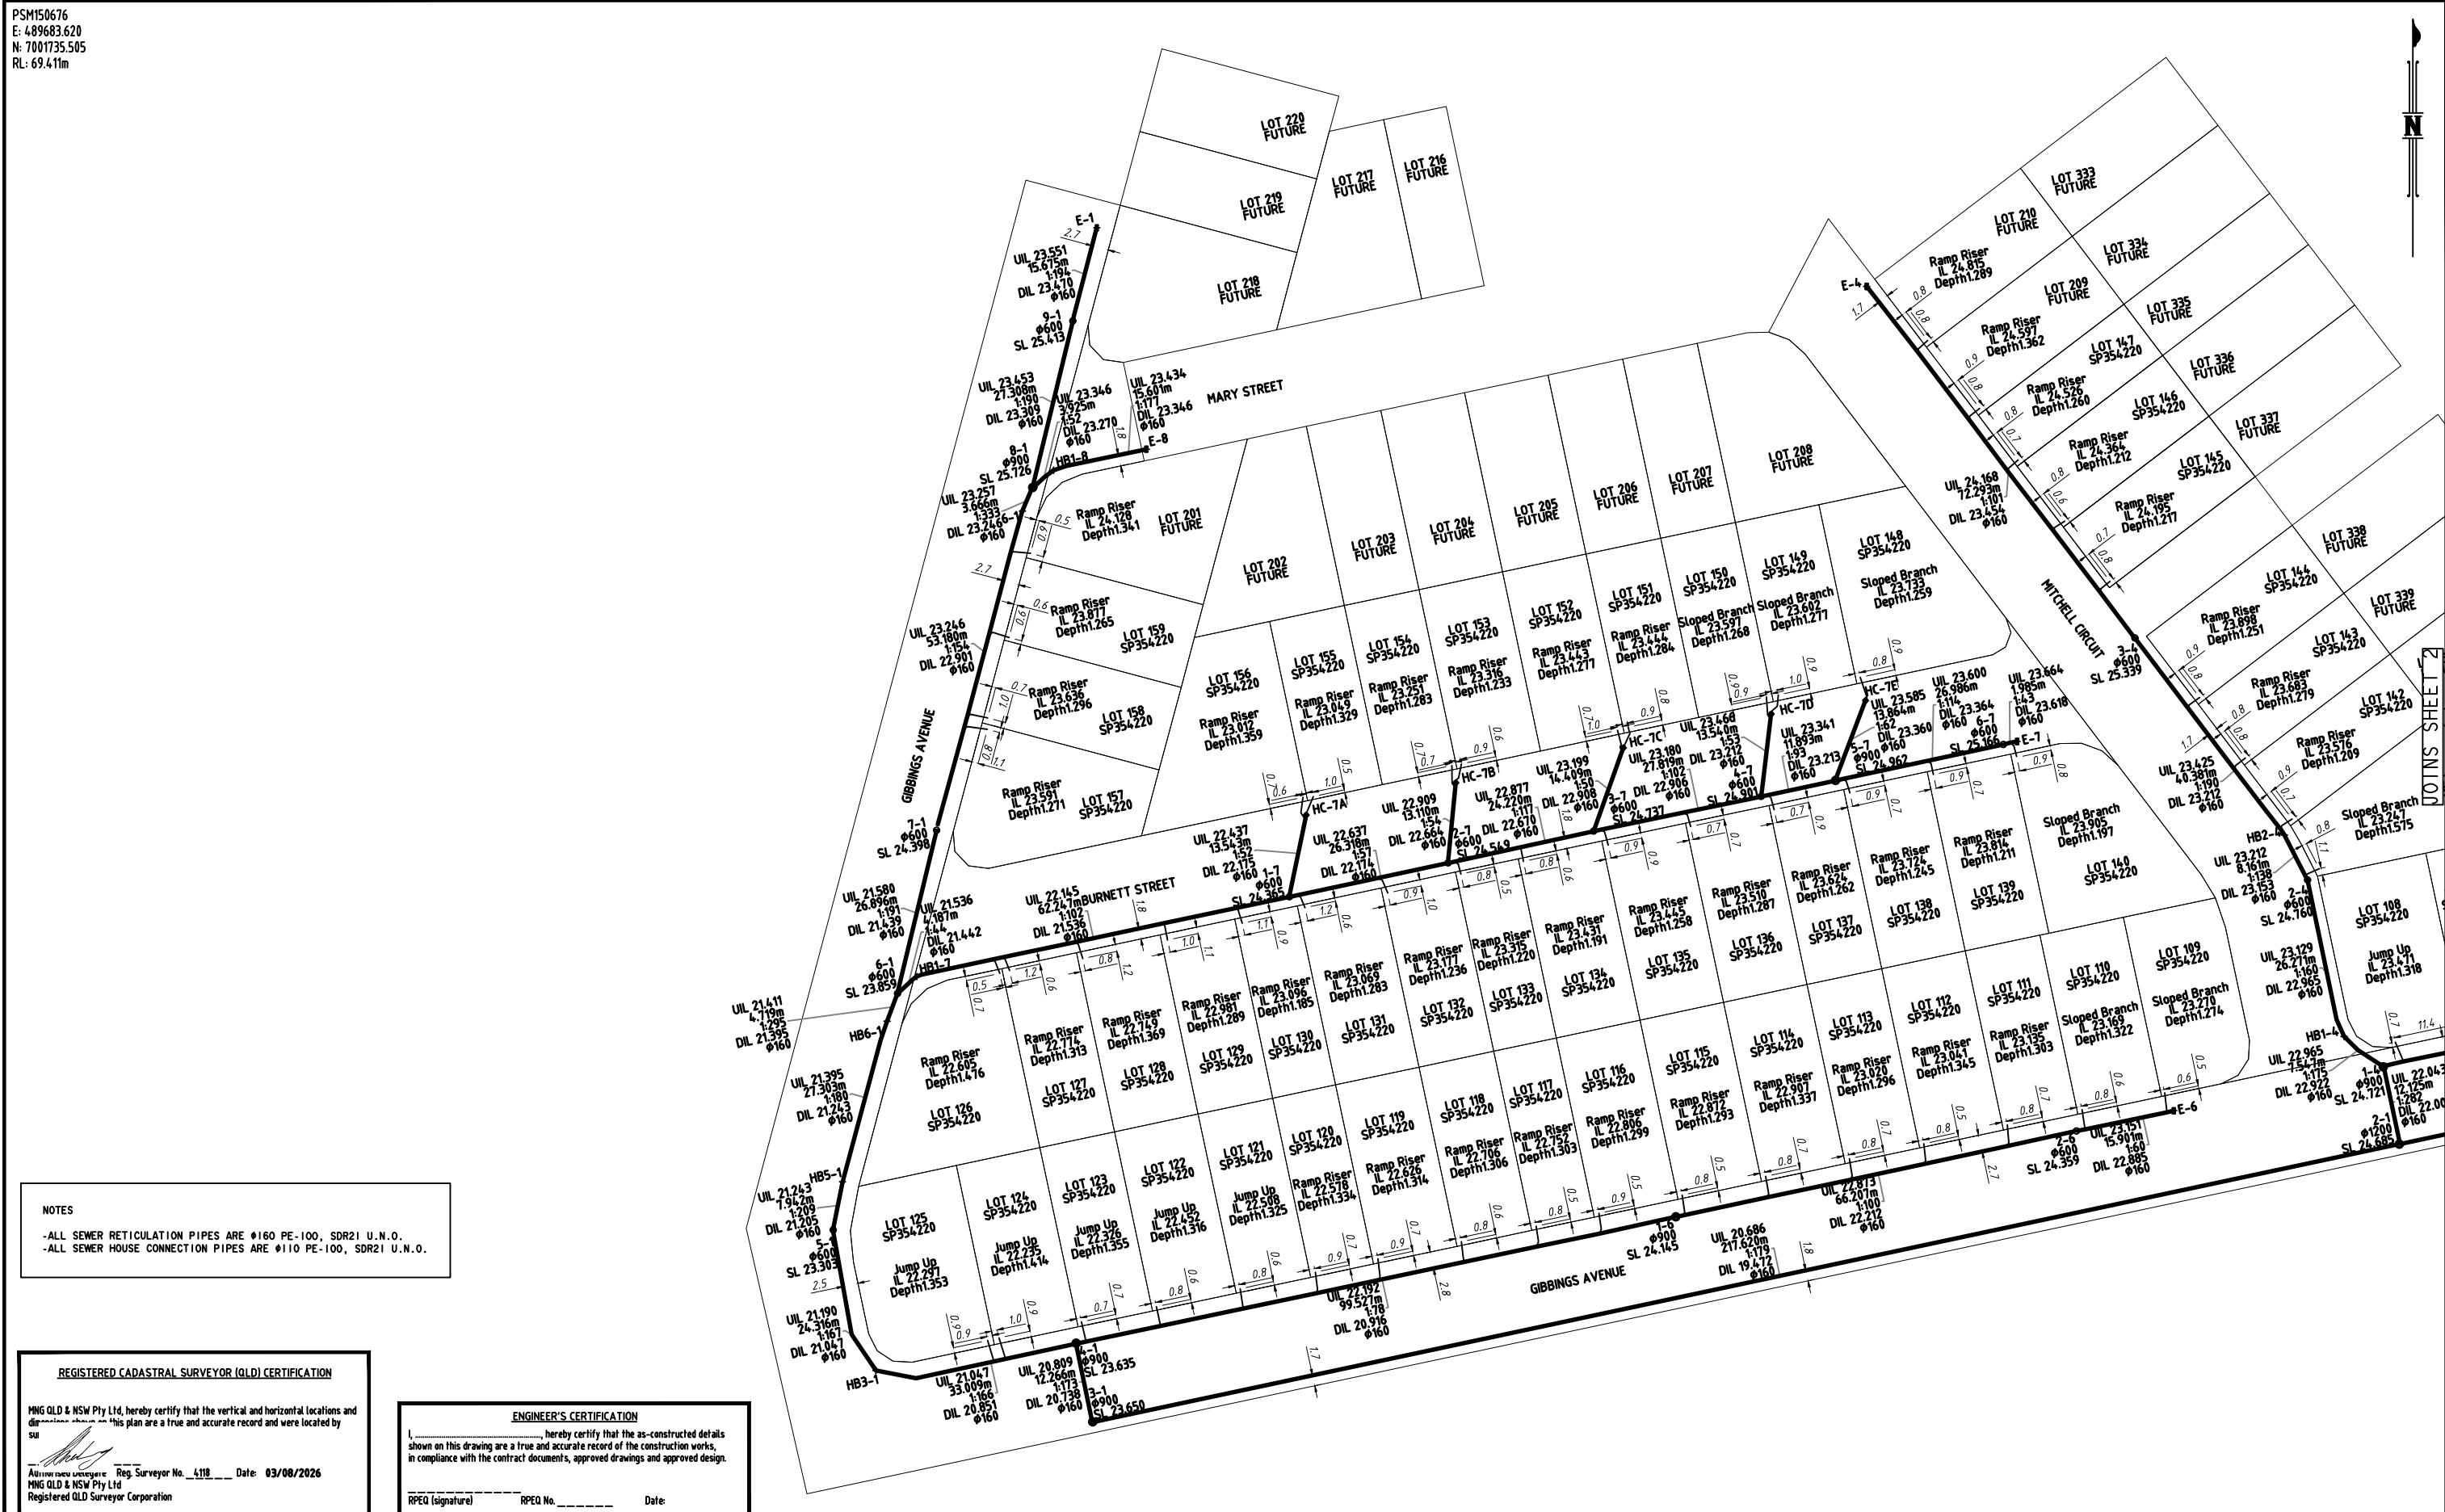



PSM150676
E: 489683.620
N: 7001735.505
RL: 69.411m

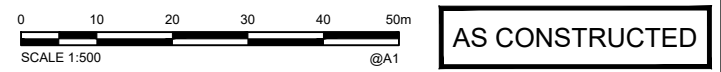

COORDINATE DATUM NOTE:
HORIZONTAL COORDINATES(E,N) SUPPLIED ARE MAPPING GRID OF AUSTRALIA(MGA), ZONE 56 BASED ON THE UNIVERSAL TRANSVERSE MERCATOR PROJECTION AND THE GEOCENTRIC DATUM OF AUSTRALIA 2020.

[illegible]

PSM150676
E: 489683.620
N: 7001735.505
RL: 69.41m

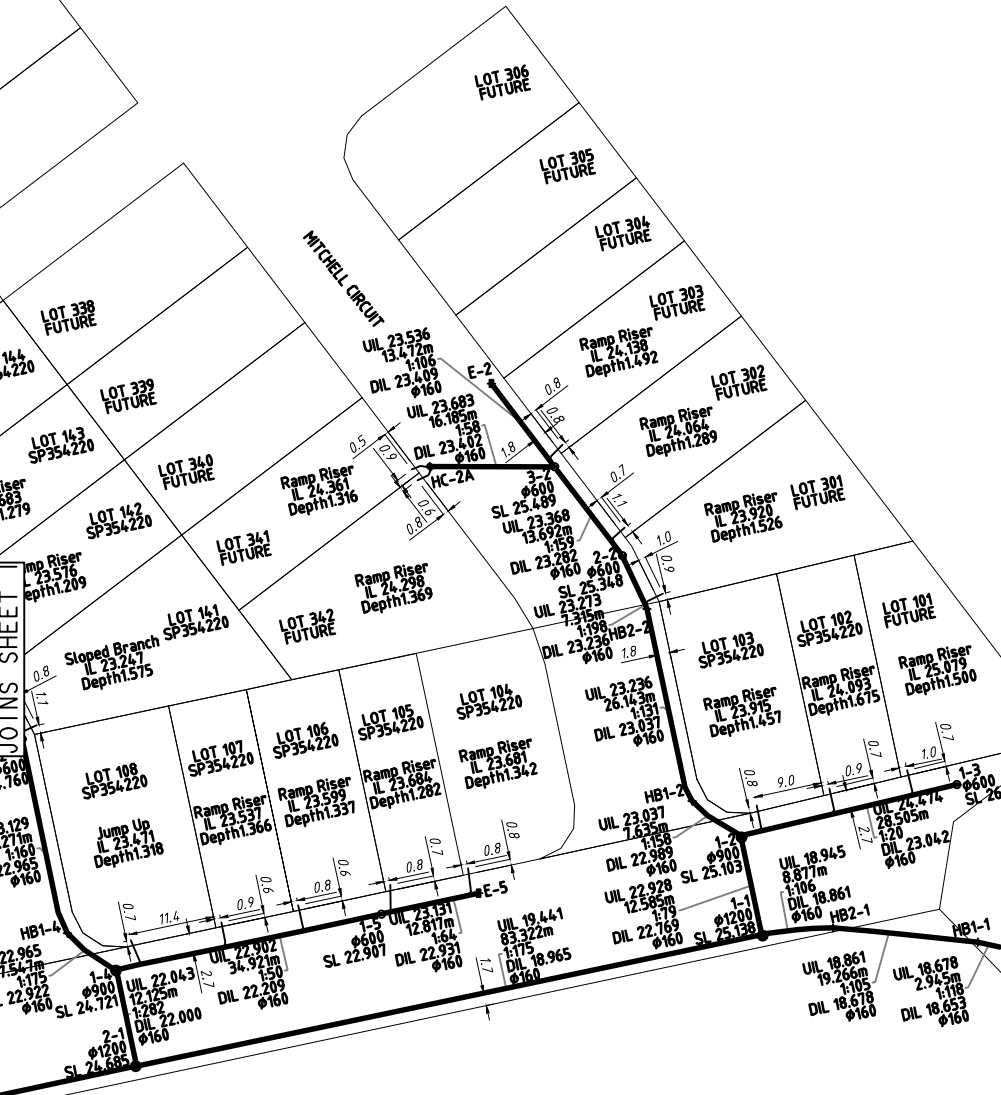

NOTES

- ALL SEWER RETICULATION PIPES ARE Ø160 PE-100, SDR21 U.N.O.
- ALL SEWER HOUSE CONNECTION PIPES ARE Ø110 PE-100, SDR21 U.N.O.

REGISTERED CADASTRAL SURVEYOR (QLD) CERTIFICATION

MNG QLD & NSW Pty Ltd, hereby certify that the vertical and horizontal locations and dimensions shown on this plan are a true and accurate record and were located by

[Signature]

Authorised Signatory Reg. Surveyor No. 4118 Date: 03/08/2026


MNG QLD & NSW Pty Ltd
Registered QLD Surveyor Corporation

ENGINEER'S CERTIFICATION

I, _____, hereby certify that the as-constructed details shown on this drawing are a true and accurate record of the construction works, in compliance with the contract documents, approved drawings and approved design.

RPEQ (signature) RPEQ No. _____ Date: _____

COORDINATE DATUM NOTE:
HORIZONTAL COORDINATES(E,N) SUPPLIED ARE MAPPING GRID OF AUSTRALIA(MGA), ZONE 56 BASED ON THE UNIVERSAL TRANSVERSE MERCATOR PROJECTION AND THE GEOCENTRIC DATUM OF AUSTRALIA 2020.

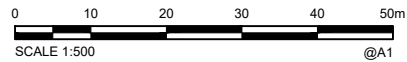

AS CONSTRUCTED

A1

INDEX	DATE	REVISIONS	DRAWN	CHECKED	PASSED	INITIALS	DATE
1	03/08/2026	INITIAL ISSUE	MJK	LS	LS		

DRAWN	MJK	03/08/2026
CHECKED	LS	03/08/2026
PASSED	LS	03/08/2026



Brisbane Office
Level 3
108 Wickham Street
Fortitude Valley QLD 4006

p: (07) 3842 1000
e: brisbane@mngsurvey.com.au
w: mngsurvey.com.au

Perth | Brisbane | Melbourne | Sydney | Broome | South West WA




Unitywater

APP-17510
26 GIBBINGS COURT, LILYWOOD STAGE 1
AS CONSTRUCTED - SEWER

SHEET 2 OF 4 SHEETS	SCALE 1:500
REVISION DATE 03/08/2026	REVISION 1
DISCIPLINE CODE C	
DRAWING NO. U-2025-6210	

PSM150676
E: 489683.620
N: 7001735.505
RL: 69.411m

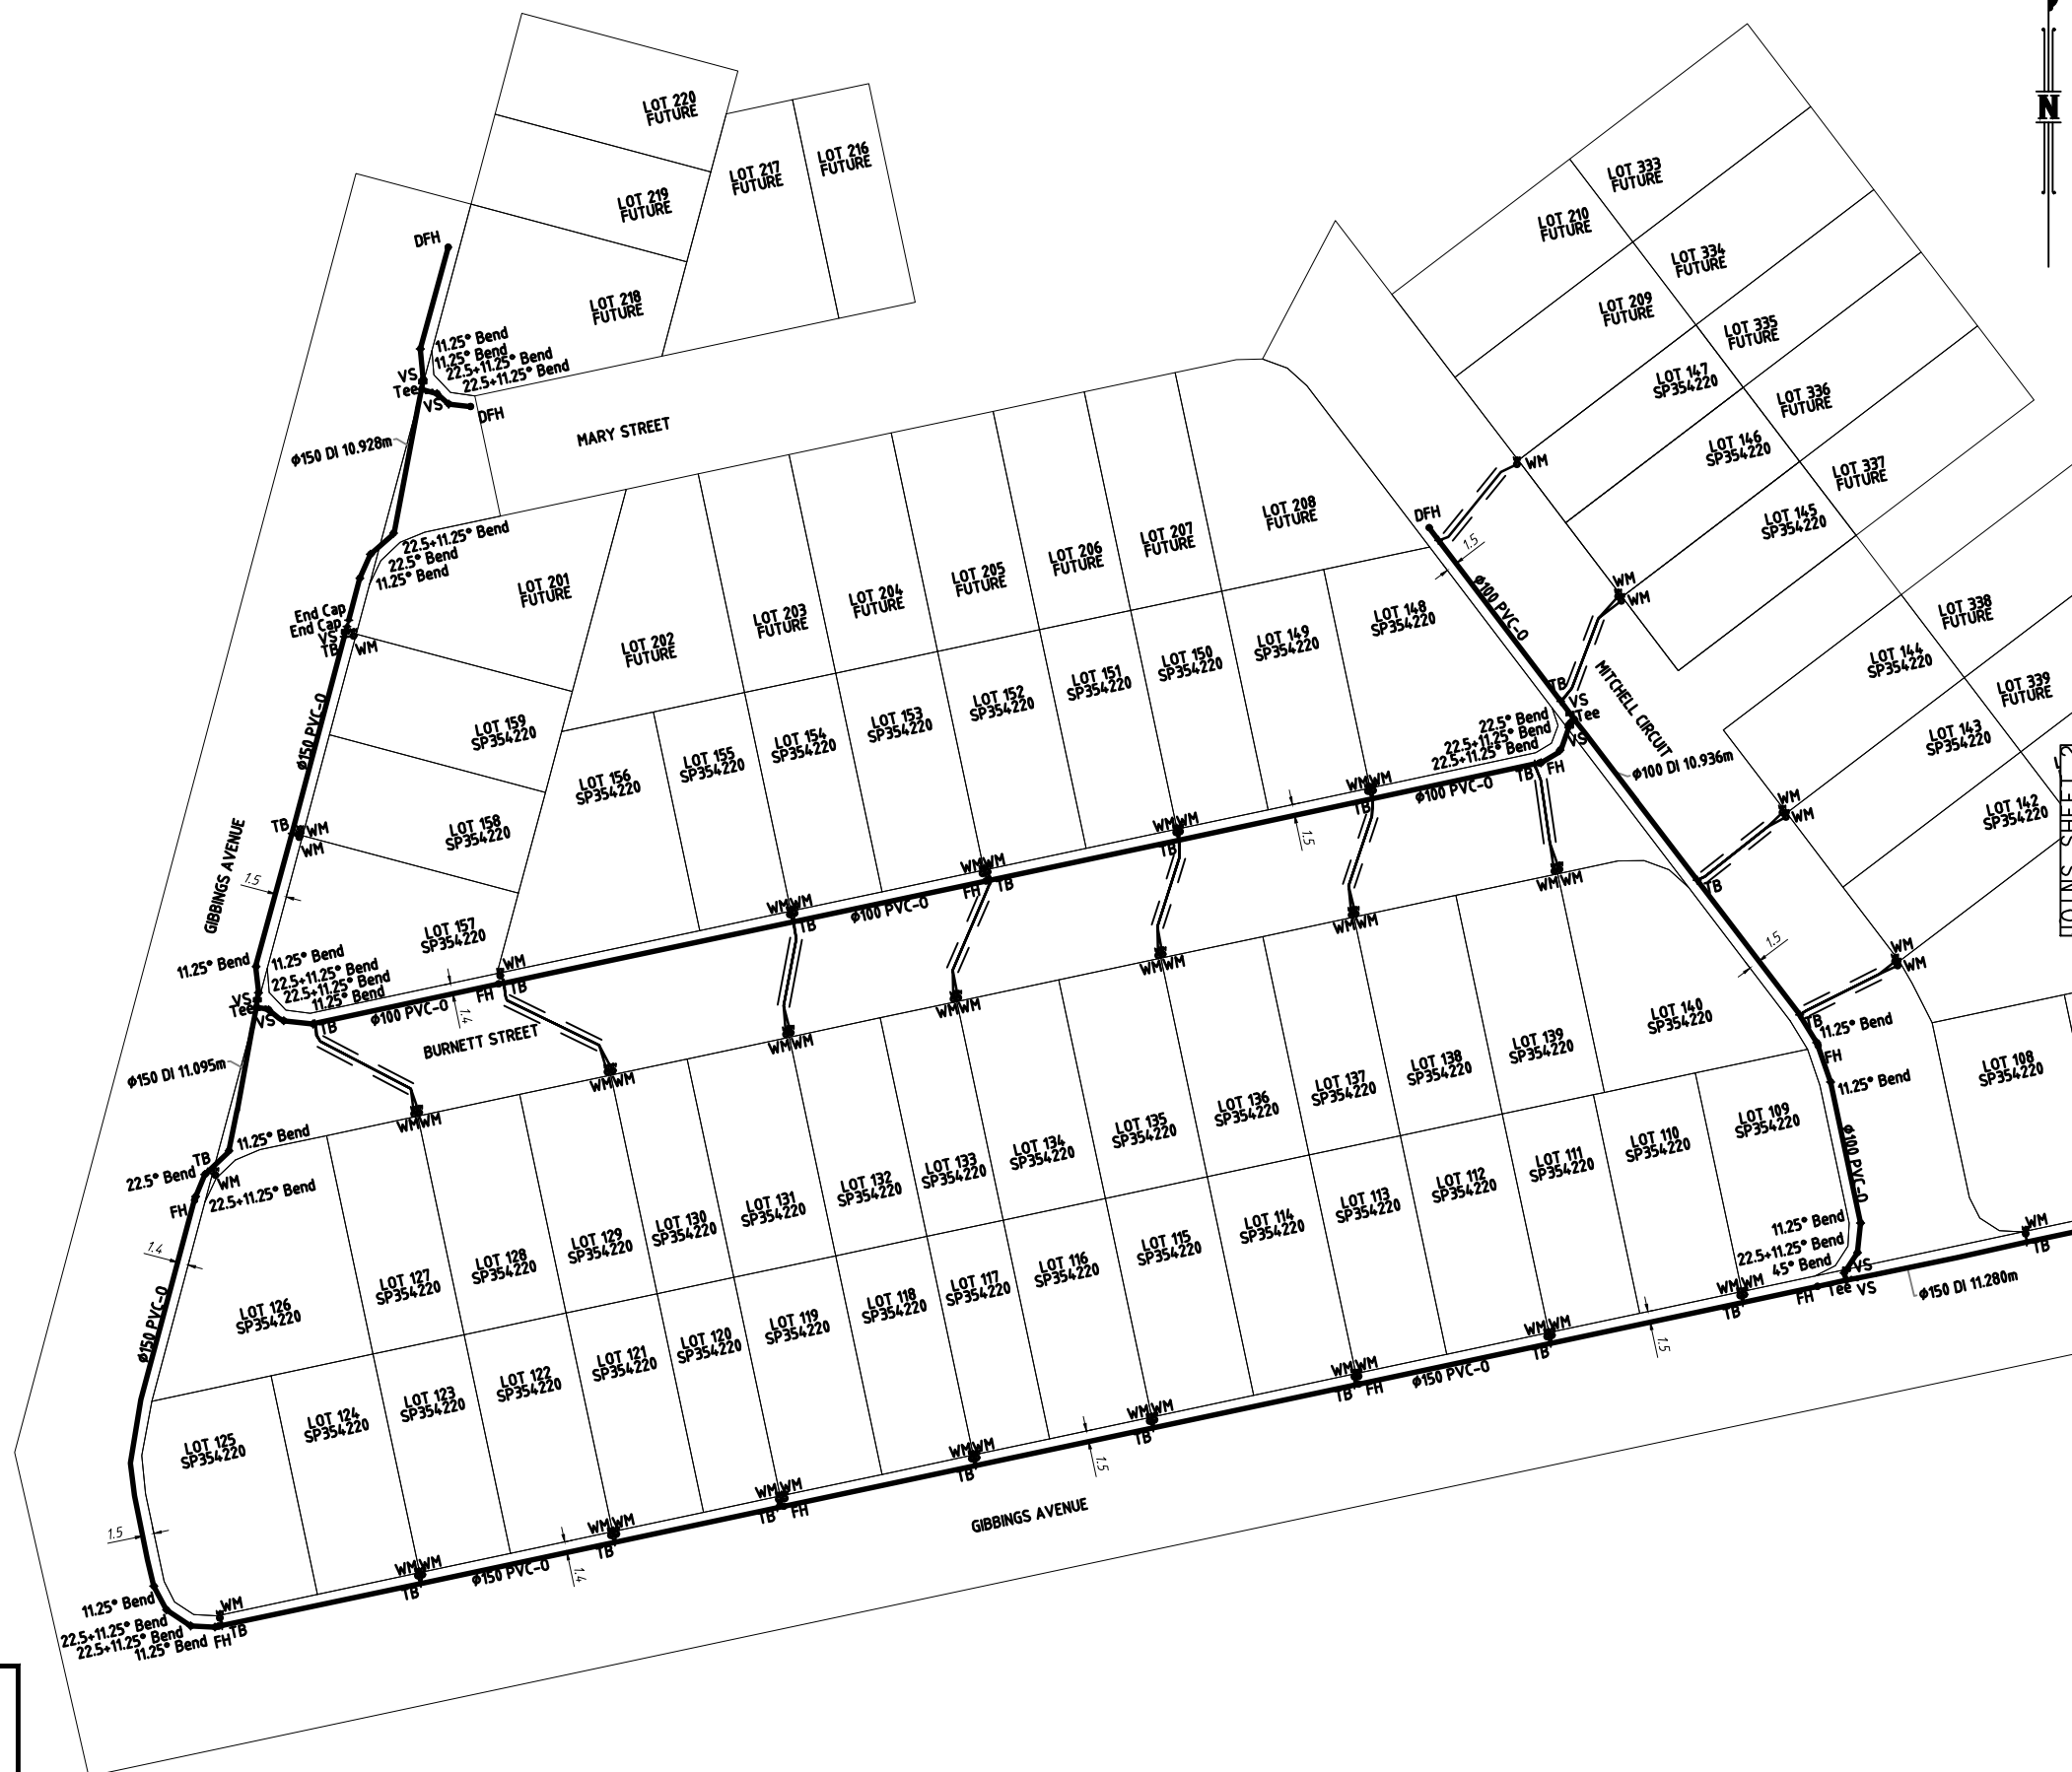

NOTES

-ALL SEWER RETICULATION PIPES ARE Ø160 PE-100, SDR21 U.N.O.
-ALL SEWER HOUSE CONNECTION PIPES ARE Ø110 PE-100, SDR21 U.N.O.

REGISTERED CADASTRAL SURVEYOR (QLD) CERTIFICATION

MNG QLD & NSW Pty Ltd, hereby certify that the vertical and horizontal locations and dimensions shown on this plan are a true and accurate record and were located by



 Ming QLD & NSW Pty Ltd
 Registered QLD Surveyor Corporation


ENGINEER'S CERTIFICATION

I, _____, hereby certify that the as-constructed details shown on this drawing are a true and accurate record of the construction works, in compliance with the contract documents, approved drawings and approved design.

RPEQ (signature) RPEQ No. Date:

COORDINATE DATUM NOTE:

HORIZONTAL COORDINATES(E,N) SUPPLIED ARE MAPPING GRID OF AUSTRALIA(MGA), ZONE 56 BASED ON THE UNIVERSAL TRANSVERSE MERCATOR PROJECTION AND THE GEOCENTRIC DATUM OF AUSTRALIA 2020.

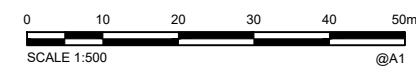

AS CONSTRUCTED

[illegible]

Perth | Brisbane | Melbourne | Sydney | Broome | South West WA



Unitywater

APP-17510
26 GIBBINGS COURT, LILYWOOD STAGE 1
AS CONSTRUCTED - WATER

SHEET 3 OF 4 SHEETS		SCALE 1:500	
REVISION DATE 03/08/2026		REVISION 1	
DISCIPLINE CODE C			
DRAWING NO. U-2025-6210			

