JOINS DIAG 'A'



UIL 25.242
DIL 24.960
L=76.852
1:273
ø375

G42-20
935x830
SL27.447

UIL 24.888
DIL 24.674
L=64.448
1:301
ø450

G41-20
935x830
SL27.122

UIL 24.624
DIL 24.438
L=23.260
1:125
ø450

G40-20
935x830
SL26.940

UIL 24.398
DIL 24.091
L=78.590
1:256
ø450

UIL 24.876
DIL 24.769
L=8.885
1:83
ø375

G28-26
935x830
SL26.182

UIL 24.309
DIL 24.219
L=19.723
1:219
ø375

G39-20
935x830
SL26.066

UIL 24.079
DIL 23.950
L=16.388
1:127
ø525

4-20
ø1350
SL25.691

G47-25
935x830
SL25.648

G56-29
935x830
SL25.801

UIL 24.343
DIL 24.142
L=20.757
1:103
ø375

G55-29
935x830
SL25.644

UIL 24.557
DIL 24.348
L=35.498
1:170
ø375

UIL 26.024
DIL 25.684
L=26.531
1:78
ø375

G17-10
935x830
SL26.980

UIL 25.630
DIL 25.237
L=28.802
1:73
ø375

G16-10
935x830
SL26.610

UIL 25.165
DIL 24.141
L=82.530
1:81
ø525

G44-20
935x830
SL25.545

LOT 232 SP361339
LOT 231 SP361339
LOT 230 SP361339
LOT 229 SP361339
LOT 228 SP361339
LOT 227 SP361339
LOT 226 SP361339
LOT 225 SP361339
LOT 224 SP361339
LOT 223 SP361339
LOT 222 SP361339
LOT 221 SP361339
LOT 220 SP361339
LOT 219 SP361339
LOT 218 SP361339
LOT 217 SP361339
LOT 216 SP361339
LOT 215 SP361339
LOT 214 SP361339
LOT 213 SP361339
LOT 212 SP361339
LOT 211 SP361339
LOT 210 SP361339
LOT 209 SP361339
LOT 208 SP361339
LOT 207 SP361339
LOT 206 SP361339
LOT 205 SP361339
LOT 204 SP361339
LOT 203 SP361339
LOT 202 SP361339
LOT 201 SP361339

AVENUE
GIBBINGS
MARY
STREET
MITCHELL
CIRCUIT

REGISTERED CADASTRAL SURVEYOR (QLD) CERTIFICATION

MNG QLD & NSW Pty Ltd

Hereby
- certify the information contained in this drawing is an accurate as constructed representation of the works
- accept responsibility for the as constructed survey information contained in this drawing
- acknowledge the as constructed survey information contained in the drawing may be relied on by council and others

Authorised Delegate — 4118 Rego No. — 29/09/2026 Date
MNG QLD & NSW Pty Ltd
Registered Qld Surveyor Corporation

ENGINEERS AS CONSTRUCTED CERTIFICATION

..... RPEQ No.....
being a certified/registered engineer and duly authorised representative of:

.....

Hereby
- certify the information contained in this drawing is an accurate as constructed representation of the works
- accept responsibility for the as constructed information contained in this drawing
- acknowledge the as constructed information contained in the drawing may be relied on by council and others

Certification of stage:..... by..... on.....

For.....

NOTES

-ALL STORMWATER DRAINAGE PIPES ARE RCP CLASS '3' U.N.O

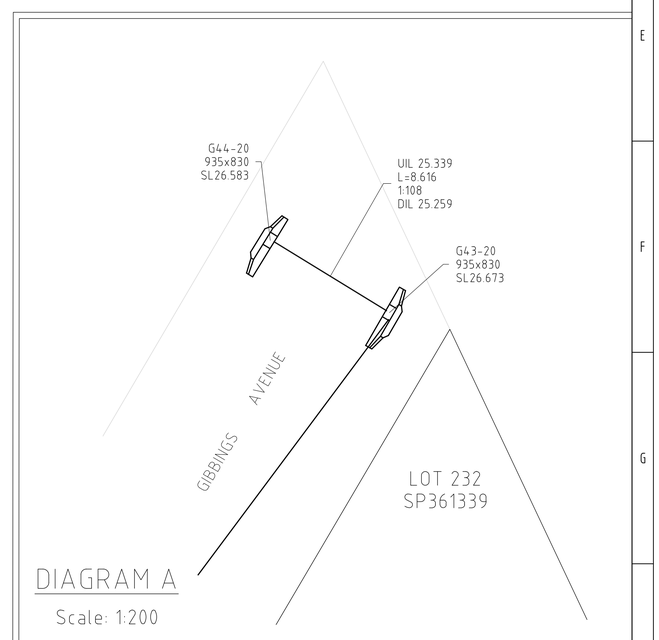


DIAGRAM A
Scale: 1:200

DRAWING REVISIONS				DESIGN FILE No.		DESIGNED	
REV.	REVISION DESCRIPTION			CONSTRUCT. No.		DATE	
1	INITIAL ISSUE			SURVEY FILE No.		DRAWN	JHK
				FIELD BOOK		DATE	25/09/2026
				LOG BOOK		CHECKED	LHS
				LEVEL DATUM		DATE	25/09/2026
				DATUM			

MNG
Brisbane Office
Level 3
108 Wickham Street
Fortitude Valley QLD 4006
p: (07) 3842 1000
e: brisbane@mngsurvey.com.au
w: mngsurvey.com.au
Perth | Brisbane | Melbourne | Sydney | Broome | South West WA

SCALE 1:500 | ORIGINAL SIZE A1

Moreton Bay Regional Council
MORETON BAY REGIONAL COUNCIL
CABOOLTURE DISTRICT OFFICE
2 HASKING STREET CABOOLTURE QLD 4510
PO BOX 159 CABOOLTURE QLD 4510
Telephone: (07) 5433 0100
Fax: (07) 5433 4000

PROPOSED RESIDENTIAL DEVELOPMENT
STAGE 2
26 GIBBINGS COURT, LILYWOOD
AS-CONSTRUCTED STORMWATER

SUBDIVISION REFERENCE
DA/2022/4278
PAGE NO. 1 OF 1
MNG PLAN NUMBER
BRSS8201-000-270-1