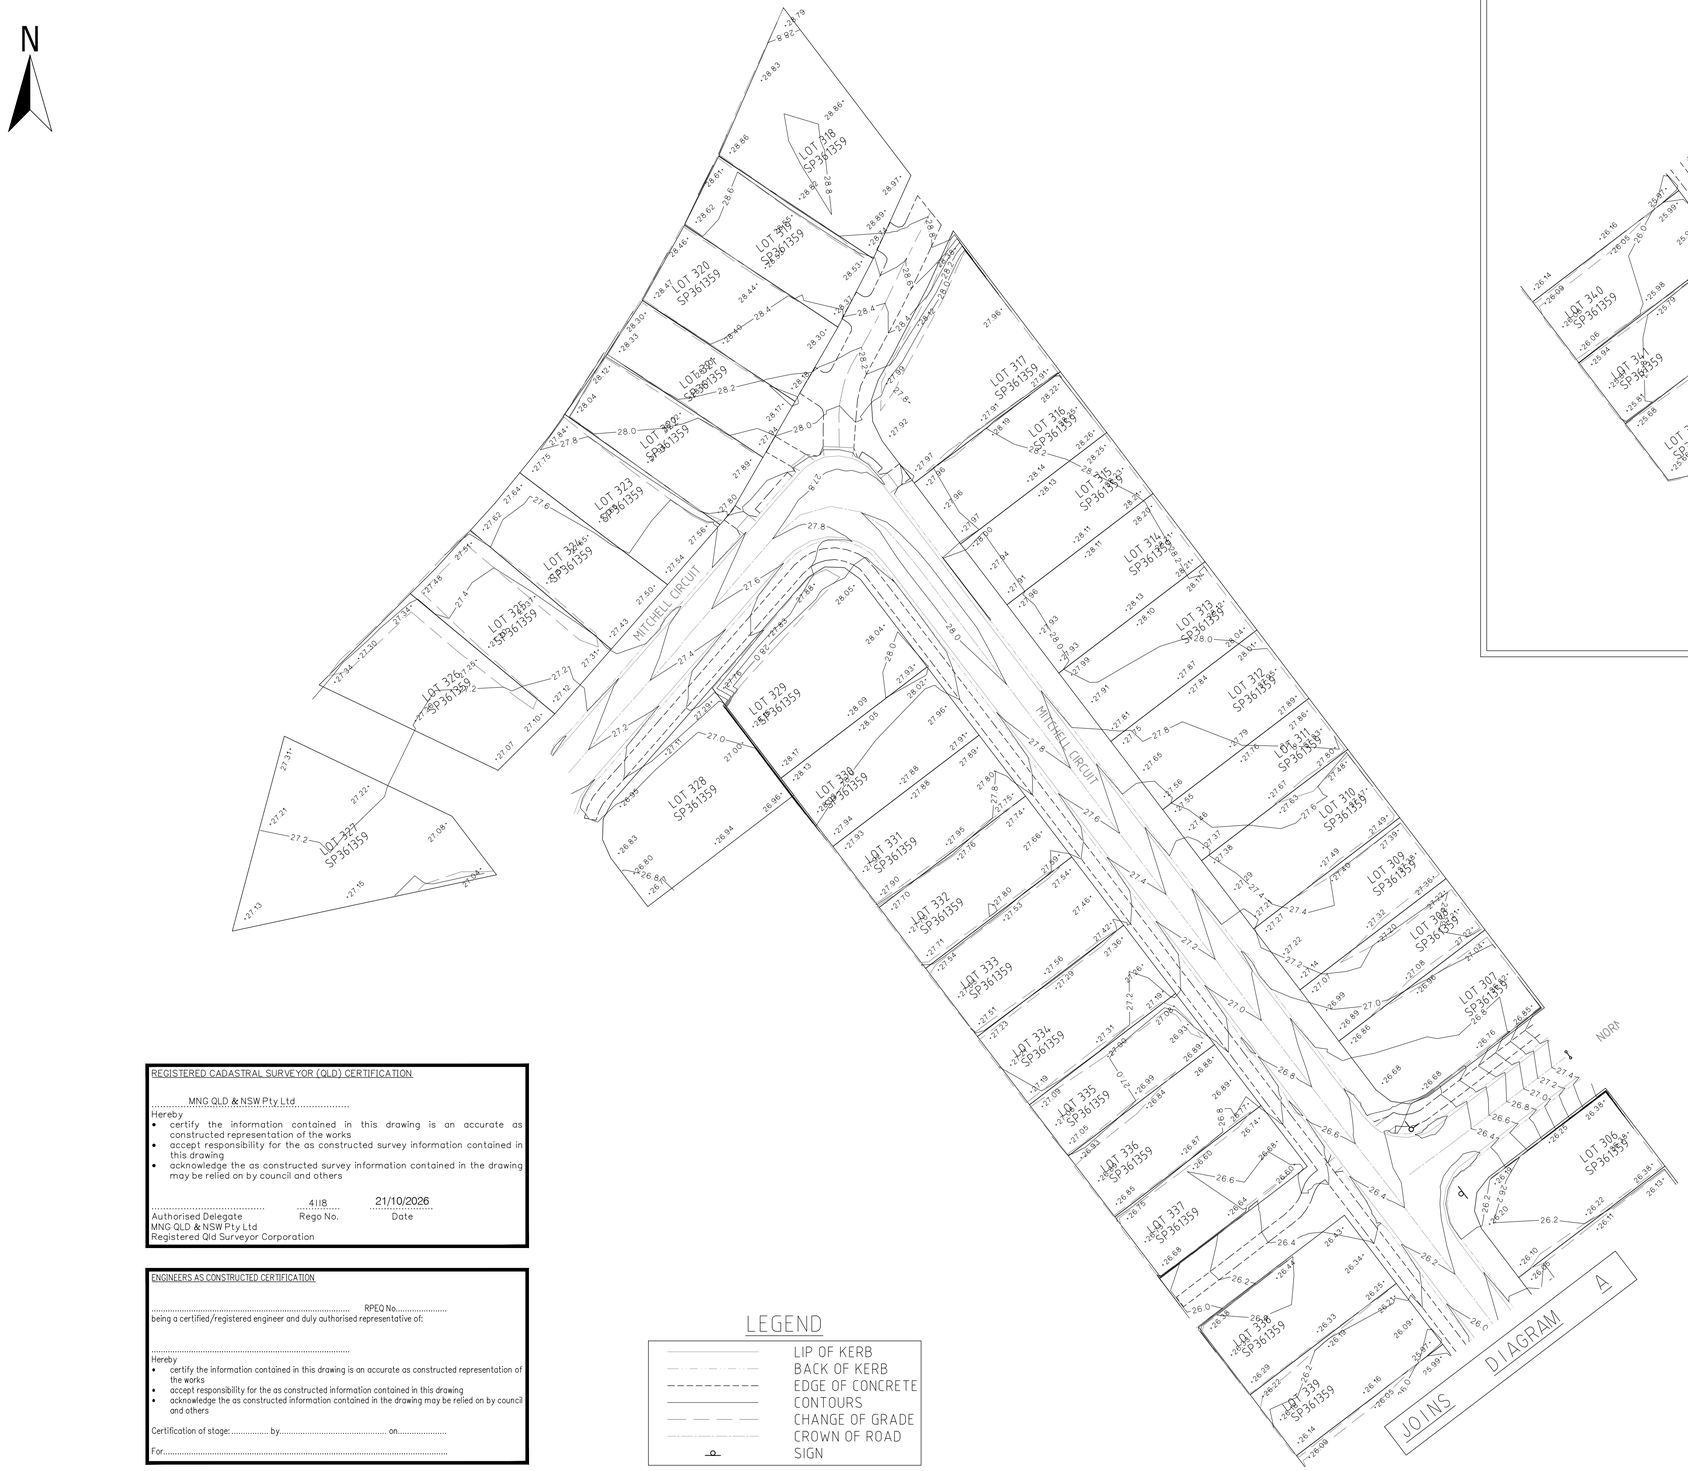


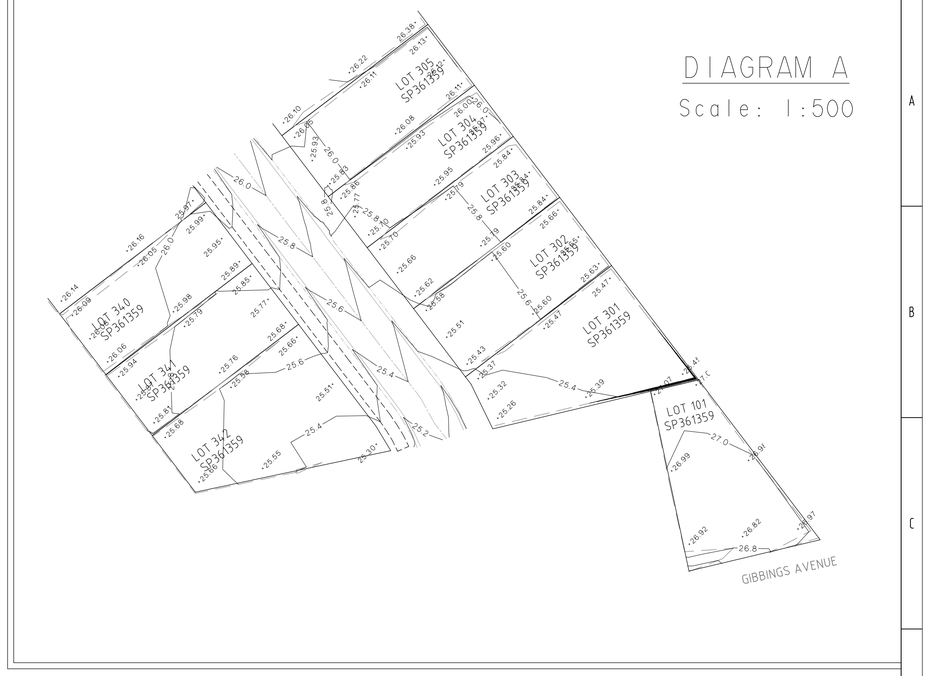


DIAGRAM A

Scale: 1:500

REGISTERED CADASTRAL SURVEYOR (QLD) CERTIFICATION

MNG QLD & NSW Pty Ltd

Hereby
- certify the information contained in this drawing is an accurate as constructed representation of the works
- accept responsibility for the as constructed survey information contained in this drawing
- acknowledge the as constructed survey information contained in the drawing may be relied on by council and others

Authorised Delegate	4118	21/10/2026
	Rego No.	Date

MNG QLD & NSW Pty Ltd
Registered Qld Surveyor Corporation

ENGINEERS AS CONSTRUCTED CERTIFICATION

..... RPEQ No.....
being a certified/registered engineer and duly authorised representative of:

.....

Hereby
- certify the information contained in this drawing is an accurate as constructed representation of the works
- accept responsibility for the as constructed information contained in this drawing
- acknowledge the as constructed information contained in the drawing may be relied on by council and others

Certification of stage:..... by..... on.....

For.....

LEGEND

- LIP OF KERB
- BACK OF KERB
- EDGE OF CONCRETE
- CONTOURS
- CHANGE OF GRADE
- CROWN OF ROAD
- SIGN

DRAWING REVISIONS				DESIGN FILE No.		DESIGNED	
REV.	REVISION DESCRIPTION			CONSTRUCT. No.		DATE	
1	INITIAL ISSUE			SURVEY FILE No.		DRAWN	JHK
				FIELD BOOK		DATE	21/10/2026
				LOG BOOK		CHECKED	V0
				LEVEL DATUM		DATE	21/10/2026
				DATUM			

MNG
Brisbane Office
Level 3
108 Wickham Street
Fortitude Valley QLD 4006
p: (07) 3842 1000
e: brisbane@mngsurvey.com.au
w: mngsurvey.com.au
Perth | Brisbane | Melbourne | Sydney | Broome | South West WA

SCALE 1:500

ORIGINAL SIZE A1

Moreton Bay Regional Council
MORETON BAY REGIONAL COUNCIL
CABOOLTURE DISTRICT OFFICE
2 HASKING STREET CABOOLTURE QLD 4510
PO BOX 159 CABOOLTURE QLD 4510
Telephone: (07) 5433 0100
Fax: (07) 5433 4000

PROPOSED RESIDENTIAL DEVELOPMENT
STAGE 3
26 GIBBINGS COURT, LILYWOOD
AS-CONSTRUCTED TOPOGRAPHY

SUBDIVISION REFERENCE
DA/2022/4278
PAGE NO. 1 OF 1
LPL PLAN NUMBER
BRSS8201-000-278-1