

PSM150676
E: 489683.620
N: 7001735.505
RL: 69.411m

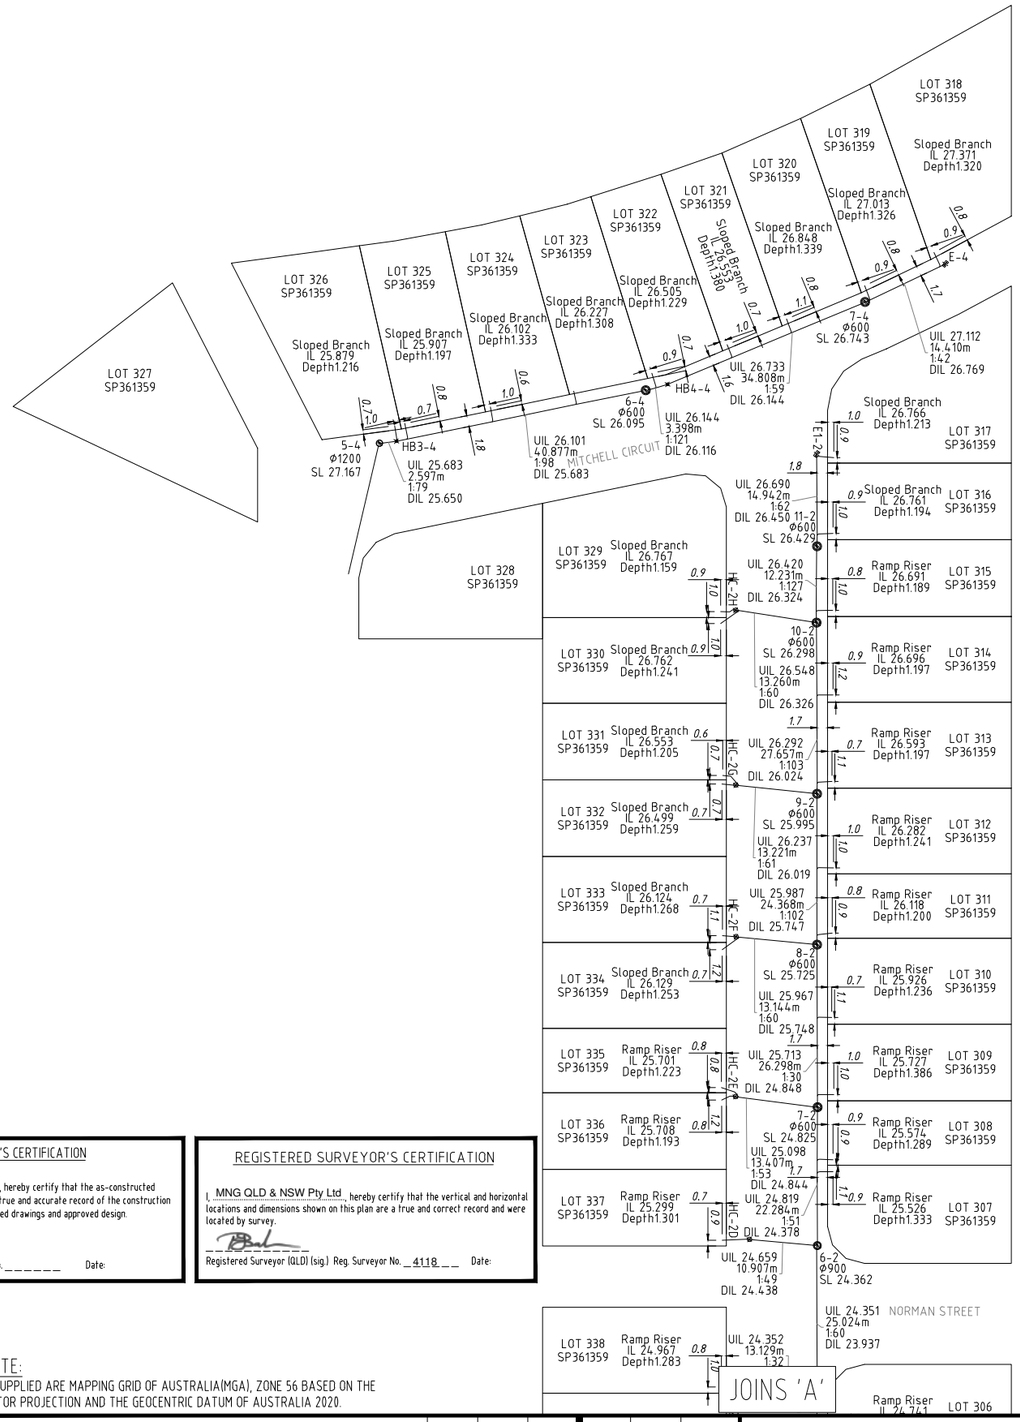

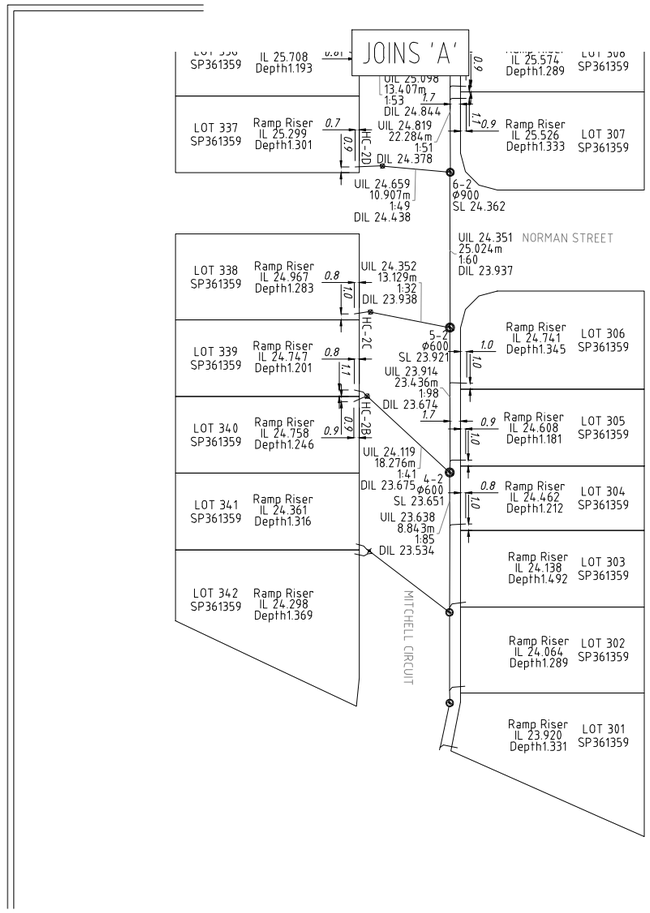



ENGINEER'S CERTIFICATION

I, ..., hereby certify that the as-constructed details shown on this drawing are a true and accurate record of the construction works, in compliance with the approved drawings and approved design.

_____
RPEQ (signature) RPEQ No. _____ Date:

REGISTERED SURVEYOR'S CERTIFICATION

I, MNG QLD & NSW Pty Ltd, hereby certify that the vertical and horizontal locations and dimensions shown on this plan are a true and correct record and were located by survey.

_____
Registered Surveyor (QLD) (sig.) Reg. Surveyor No. 4118 Date:

COORDINATE DATUM NOTE:
HORIZONTAL COORDINATES(E,N) SUPPLIED ARE MAPPING GRID OF AUSTRALIA(MGA), ZONE 56 BASED ON THE UNIVERSAL TRANSVERSE MERCATOR PROJECTION AND THE GEOCENTRIC DATUM OF AUSTRALIA 2020.

0 10 20 30 40 50m
SCALE 1:500 @A1

AS CONSTRUCTED

A1

INDEX	DATE	REVISIONS	DRAWN	CHECKED	PASSED
1	22/10/2026	INITIAL ISSUE	MJK	PJB	PJB

	INITIALS	DATE
DRAWN	MJK	22/10/2026
CHECKED	PJB	22/10/2026
PASSED	PJB	22/10/2026

MNG
Brisbane Office
Level 3
108 Wickham Street
Fortitude Valley QLD 4006
p: (07) 3842 1000
e: brisbane@mngsurvey.com.au
w: mngsurvey.com.au
Perth | Brisbane | Melbourne | Sydney | Broome | South West WA


Unitywater


Unitywater
APP-25259
Lilywood Stage 3
As-Constructued Sewer

SHEET 1 OF 2 SHEETS		SCALE 1:500	
REVISION DATE	22/10/2026	REVISION	1
DISCIPLINE CODE	C		
DRAWING NO.	U-2026-6588		

Copyright © 2011 Unitywater, All Rights Reserved

PSM150676
E: 489683.620
N: 7001735.505
RL: 69.411m

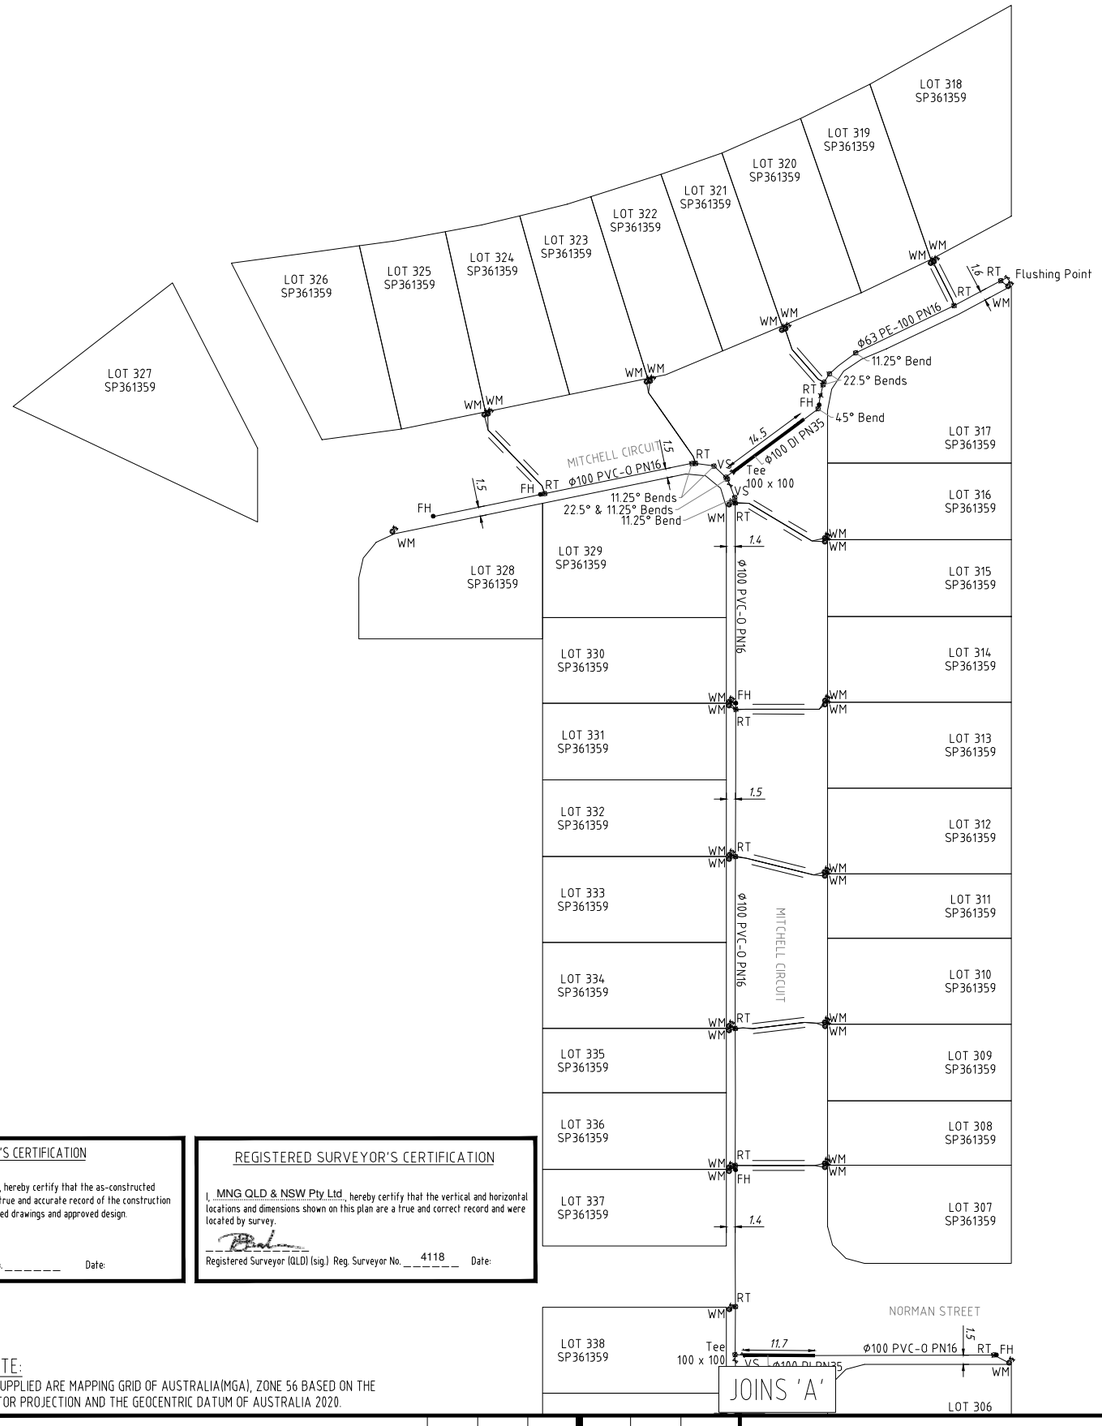

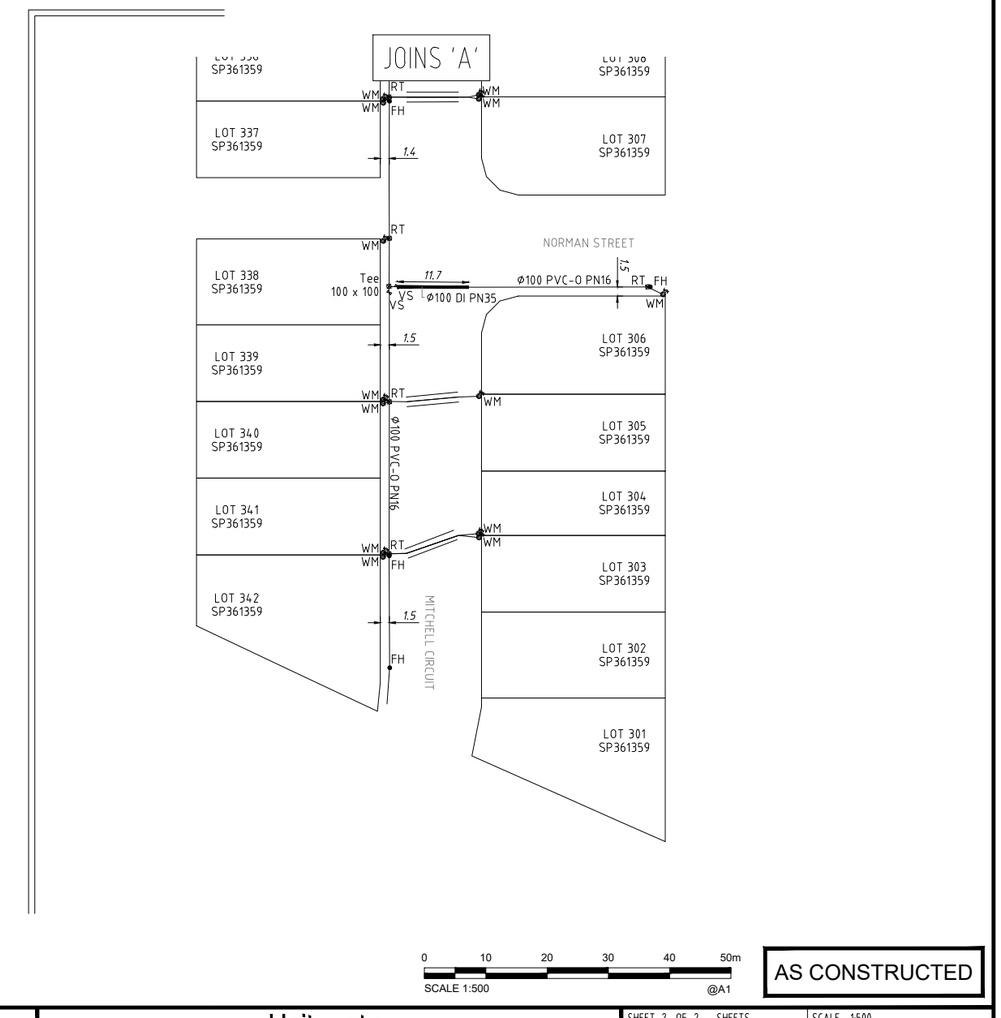

0 10 20 30 40 50m
SCALE 1:500 @A1

AS CONSTRUCTED

ENGINEER'S CERTIFICATION

I, _____, hereby certify that the as-constructed details shown on this drawing are a true and accurate record of the construction works, in compliance with the approved drawings and approved design.

_____
RPEQ (signature) RPEQ No. _____ Date:

REGISTERED SURVEYOR'S CERTIFICATION

I, MNG QLD & NSW Pty Ltd, hereby certify that the vertical and horizontal locations and dimensions shown on this plan are a true and correct record and were located by survey.

_____
Registered Surveyor (QLD) (sig.) Reg. Surveyor No. 4118 Date:

COORDINATE DATUM NOTE:

HORIZONTAL COORDINATES(E,N) SUPPLIED ARE MAPPING GRID OF AUSTRALIA(MGA), ZONE 56 BASED ON THE UNIVERSAL TRANSVERSE MERCATOR PROJECTION AND THE GEOCENTRIC DATUM OF AUSTRALIA 2020.

A1

INDEX	DATE	REVISIONS	DRAWN	CHECKED	PASSED
1	22/10/2026	INITIAL ISSUE	MJK	PJB	PJB

	INITIALS	DATE
DRAWN	MJK	22/10/2026
CHECKED	PJB	22/10/2026
PASSED	PJB	22/10/2026

MNG
Brisbane Office
Level 3
108 Wickham Street
Fortitude Valley QLD 4006
p: (07) 3842 1000
e: brisbane@mngsurvey.com.au
w: mngsurvey.com.au
Perth | Brisbane | Melbourne | Sydney | Broome | South West WA

Unitywater

Unitywater

APP-25259
Lilywood Stage 3
As-Constructued Water

SHEET 2 OF 2 SHEETS	SCALE 1:500
REVISION DATE 22/10/2026	REVISION 1
DISCIPLINE CODE C	
DRAWING NO. U-2026-6588	

Copyright © 2011 Unitywater, All Rights Reserved